W 1/4 Cor Sec 27-101-14

cert. Filed 5-16-91 by JHS

Dug on ℄ Rds for bitum. overlay project CP # 50-91-08-14


Dug a 2'x3'x4' deep hole and uncovered a 3/4"ø x 12" iron over a capped 5/8"ø iron over a 2½" bearing race (looked like pipe) 2ft deep cont. digging and uncovered triangular shaped pointed limestone 4' deep in virgin soil placed 5/8"ø iron on south side of stone and set ctrn over stone on road surface

Stone was 1.0' E & 0.4' N. of 5/8"ø iron placed by JHS

7-1-02 CPU MWE — Set 5/8"ø capped 13807 after Regrading Project.

5-11-04 CPU EJL — Set Survey Pin & Washer In R.i.t.

5-14-91 DRR/RMK 3

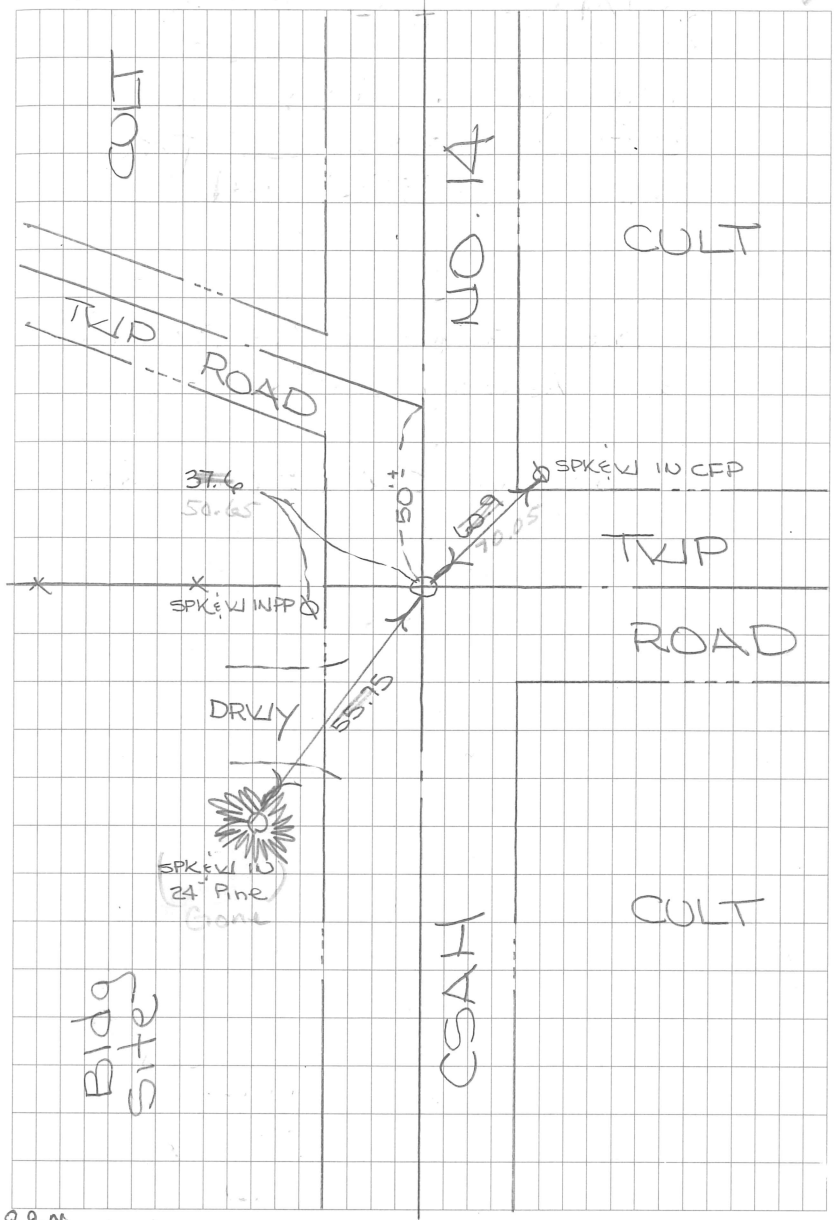

8-9-06 MAS SAT — Found Survey Marker Shot with GPS For Base Map