
SW COR SEC. 32-101-14

SET COR ON STRAIGHT LINE BET SE COR SEC 32 & S 1/4 COR SEC 31 IN LINE WITH FENCE TO NORTH

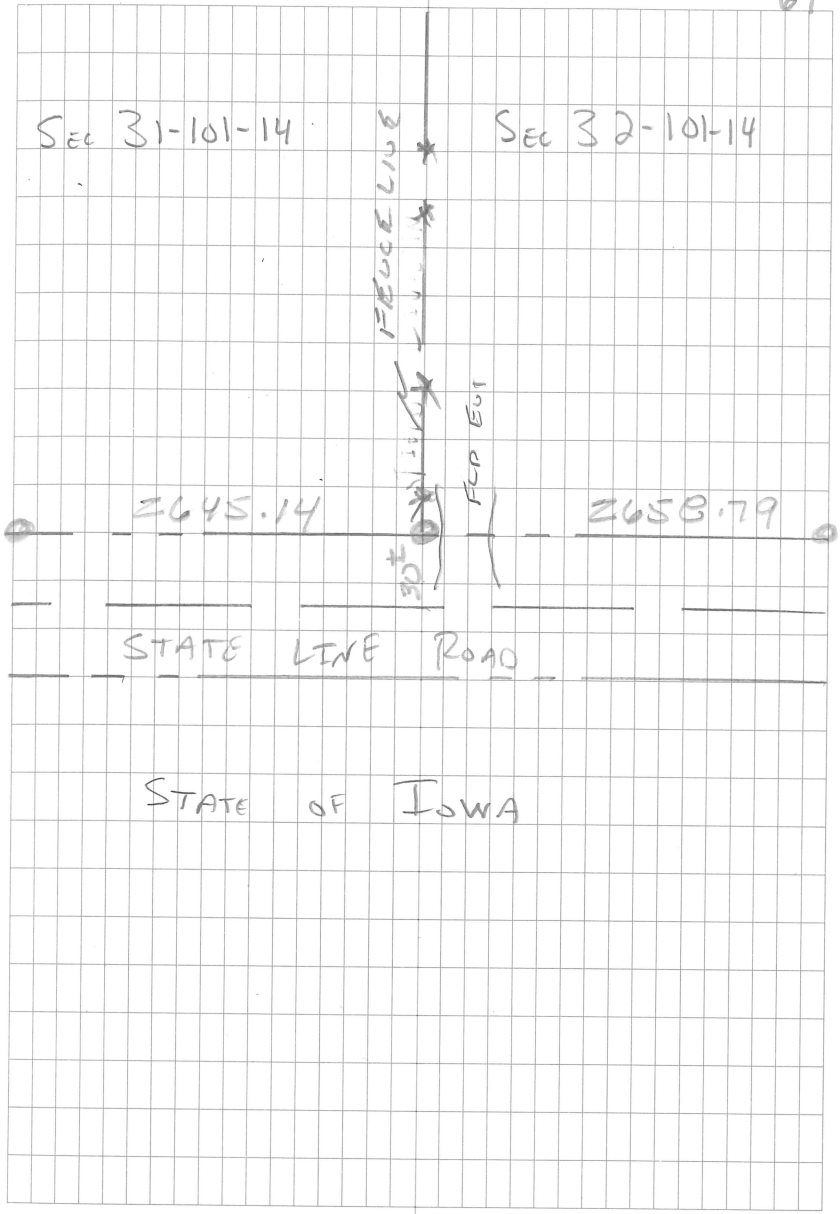

7-15-03 Cloudy 80° HLS TLM 45

SE corn SEC. 31-101-14

Corner in North Rd. Ditch of State Line Rd.
Line Fc. North.
Also Field Or. Way just East of Line Fence North.
Could not locate corner.

