N¼ Cor Sec. 32 - 101 - 14

Cert. Filed 5-13-96 by JHS DRR

10-16-94 Dug with County Backhoe and Found Large OLD Bridge Spk. driven into old wood post 2' deep in Virgin Soil Set Cim Over


7-18-94 Regrading of Twp Rd. HLS KTW

JHS Crew Tied off Cor. to South. Placed (2) 5/8" ø Irons Found 1" Iron - Pulled Tie from cut off PP. Tie Fit. No other Ties were left.

HLS KTW

8-23-94 JHS Crew Reset Cor. used 5/8" ø Irons to South. Placed 5/8" ø Iron with Cast Iron Mon Over, on Shoulder of Twp. Rd.

8-23-94 Cloudy 75° HLS KTW 16

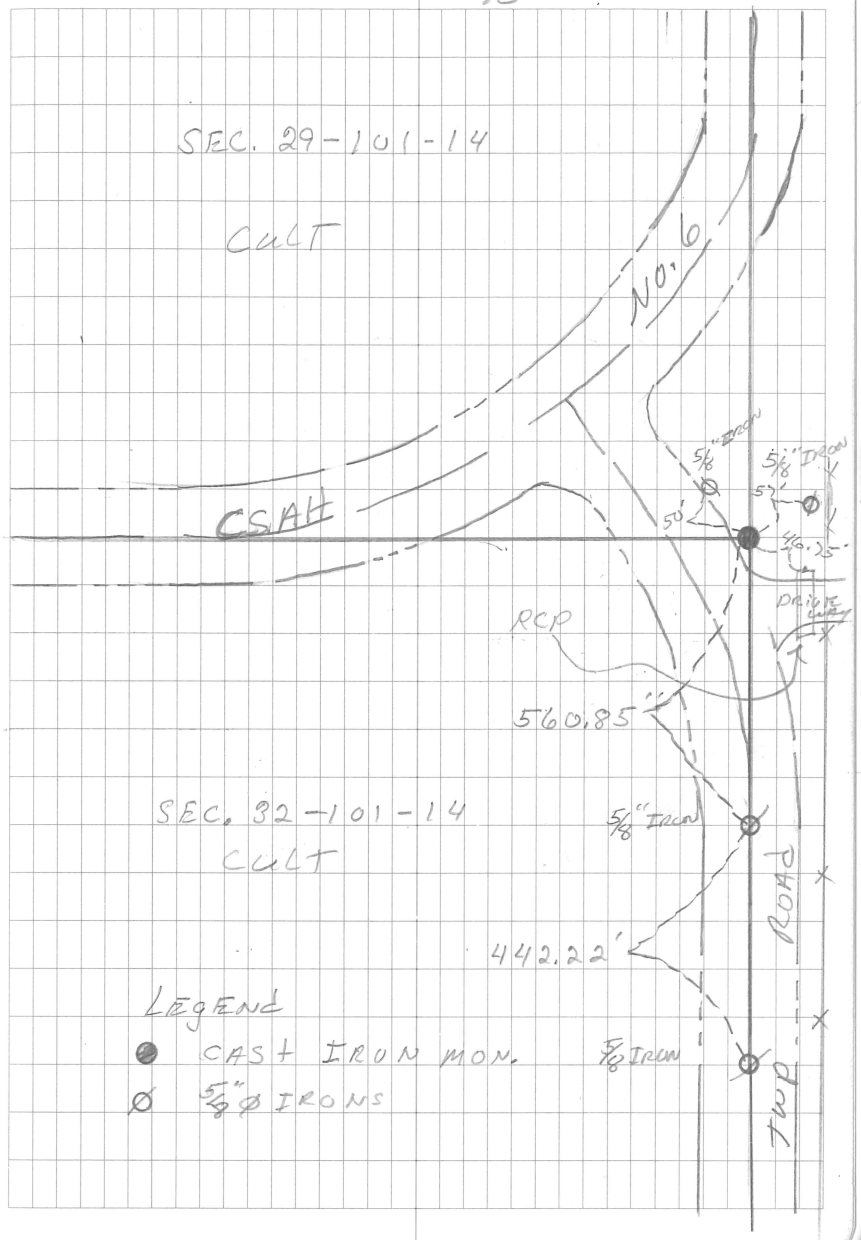

N1/4 Cor Sec 32-101-14

SEE Pg. 16

Dug with backhoe
& found large
old bridge spk?
driven into old
wood post 2' deep
in virgin soil
Set dim over
Cert. Filed 7-18-94 by JHS

7-18-94 JHS crew tied off Sec. Cor
To South Placed (2) 5/8"ø x 16"
Irons. Found 1" iron. Pulled
Tie from cut off PP. Tie Fit.
No other ties were left.

See page 30 Leroy Book 2

10-16-91 DRR ✓ 6.

