SE COR SEC. 33-101-14


JHS CREW FOUND 1/2" Ø IRON ON E ROAD TO NORTH & 33± N. OF E STATE LINE ROAD SHOT WITH GPS

10-10-06 JHS CREW dug CORNER with BACKHOE. REMOVED ½"Ø Found AND dug down BELOW. UNEQUIECKED COPPIER PIPE IN CONC. 2.5'± DEEP. LEFT MON AS found, SET 5/8" X 16" IRON with CASTIRON MON. IN PLACE of ½" Ø. .60± BELOW RD SURFACE

7-20-06 CLEAR + 90°

HLS MDH

68

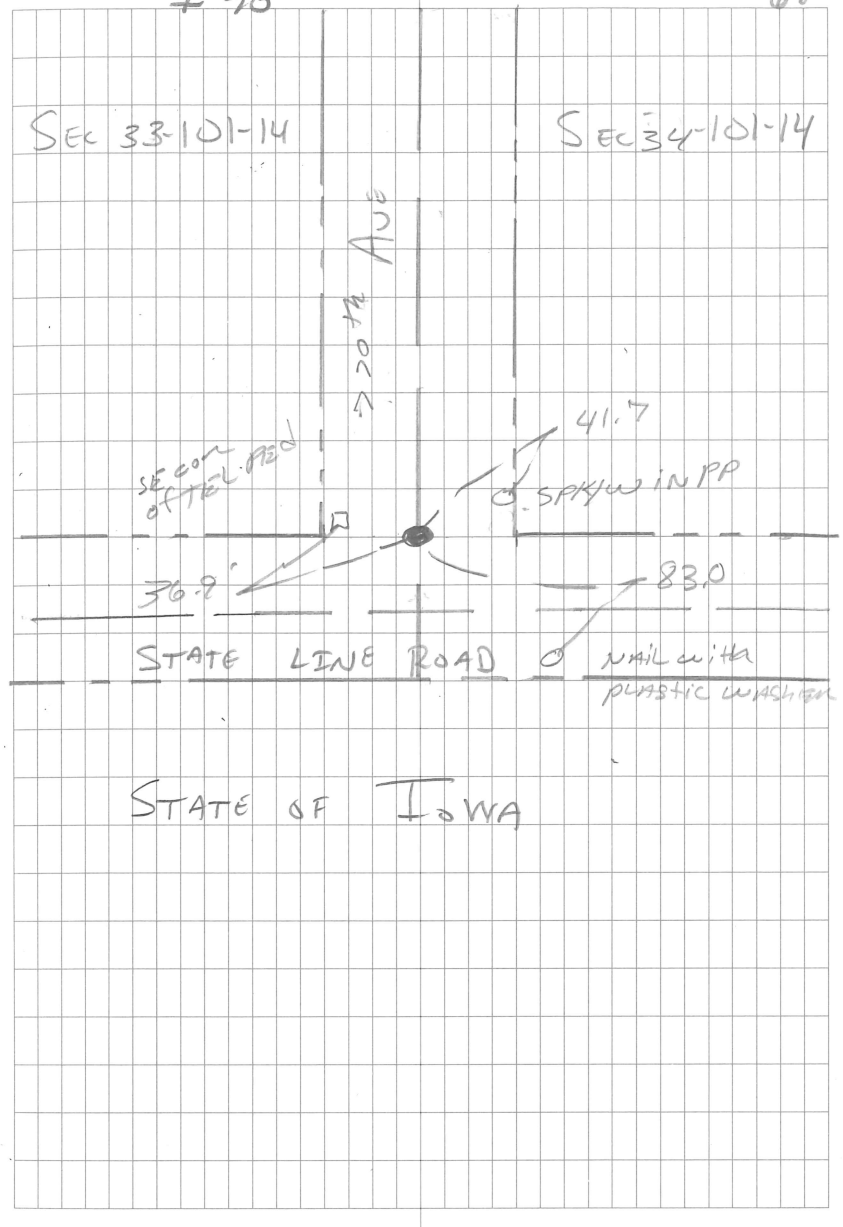

STATE OF IOWA