
SW COR SEC 36

1982
JHS CREW SEARCHED FOR THIS COR & INTER OF FENCE LINE & NORTH R/W TWP ROAD & FOUND NO PHYSICAL EVIDENCE OF COR.-

2000
JHS CREW TRAVERSED FROM SE COR SEC 36, TO SW COR SEC 35 & TIED IN EXISTING OCCUPATION & SEARCHED FOR PLS CORS & FOUND THAT CORS HAD BEEN DESTROYED BY TWP ROAD CONSTRUCTION. WE THEN COMPUTED THE LOCATION OF THIS COR ON STRAIGHT LINE BETWEEN SW COR SEC 35 IN LINE WITH FENCE TO NORTH THIS METHOD FITS THE EXISTING OCCUPATION & THE SEC & 1/4 SEC LOCATIONS ON THIS LINE.
2004 JHS CREW SET 5/8"Ø & THIS LOCATION

9-3-04 JHS
PC CPV
7 70°

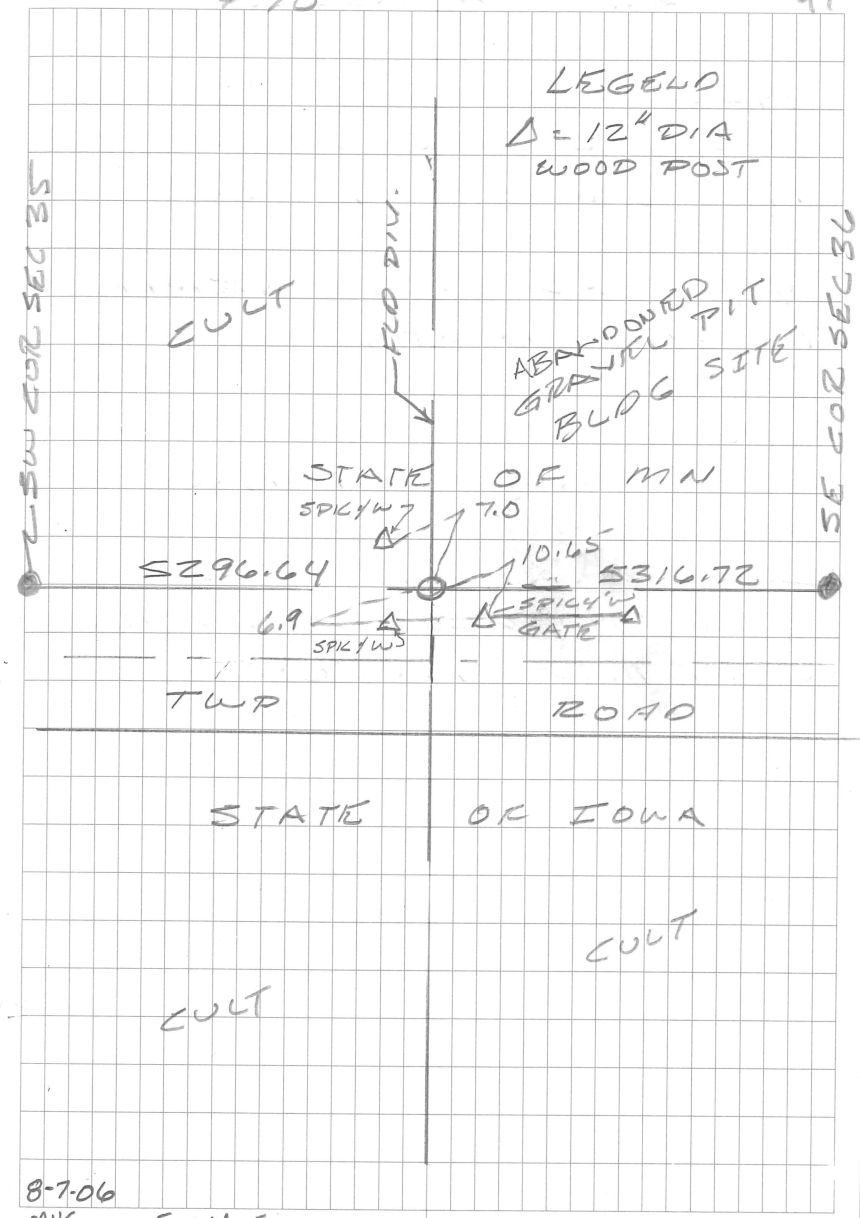

8-7-06
MHS
SAT

Found 5/8 Shot
With GPS For Basemap