
9-19-06 JHS


W 1/4 COR SEC 6

1946 MONTER CO ROAD PLAN SHOWS CORE CUT N THIS LOCATION WHICH WOULD HAVE DESTROYED ORIG MON. RESET COR USING PP/FT DIST TO CO PLAN DIST ON STRAIGHT LINE BET SEC CORS.

10-10-06 Set Survey Marker w/ GPS

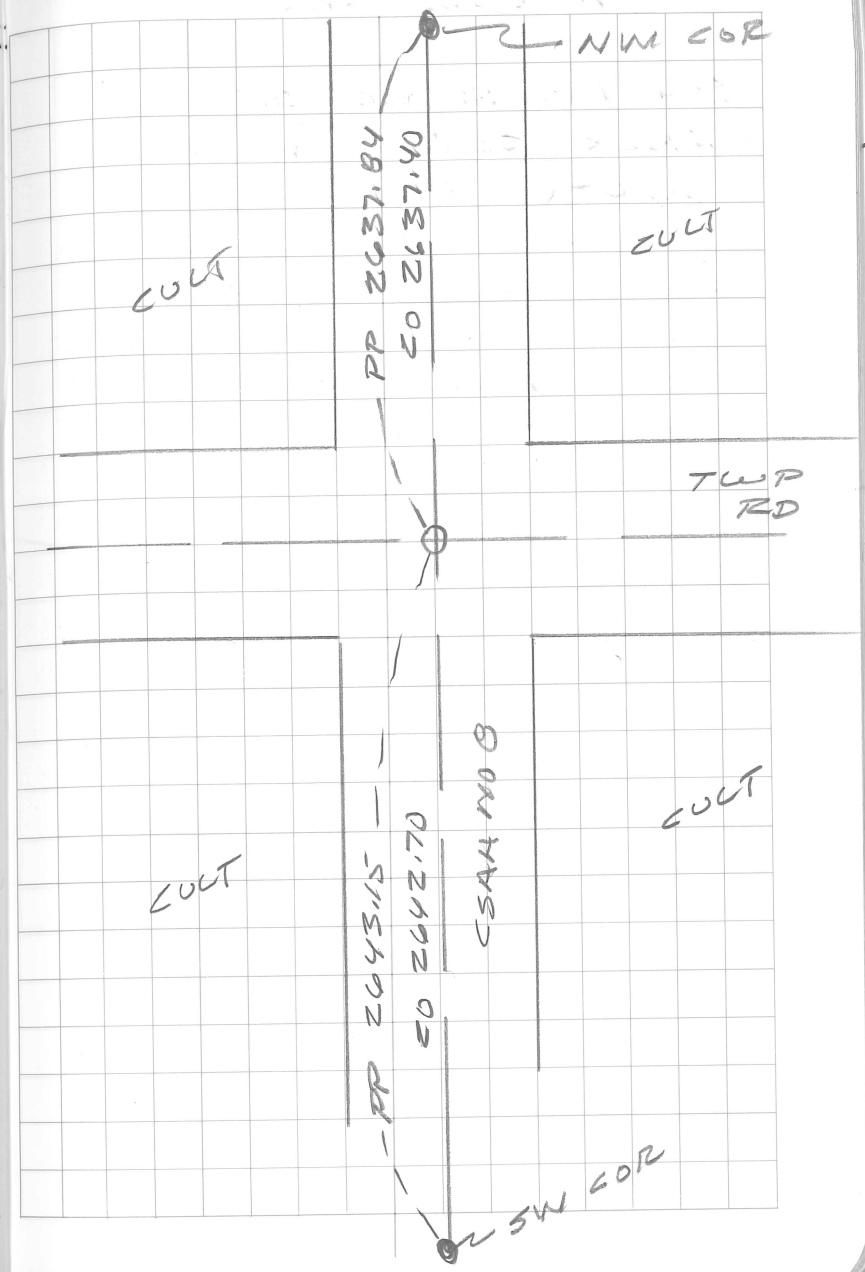

W 1/4 COR SEC 6
MOWER CO 1946 ROAD
PLAN SHOWS NO MON
⇒ THIS COR & THAT
A 2± CORE CUT WAS
MADE ⇒ THIS LOCATION
COMPUTED LOCATION OF
COR ⇒ PP/ET DIST
ON STRAIGHT LINE
BET SEC CORS

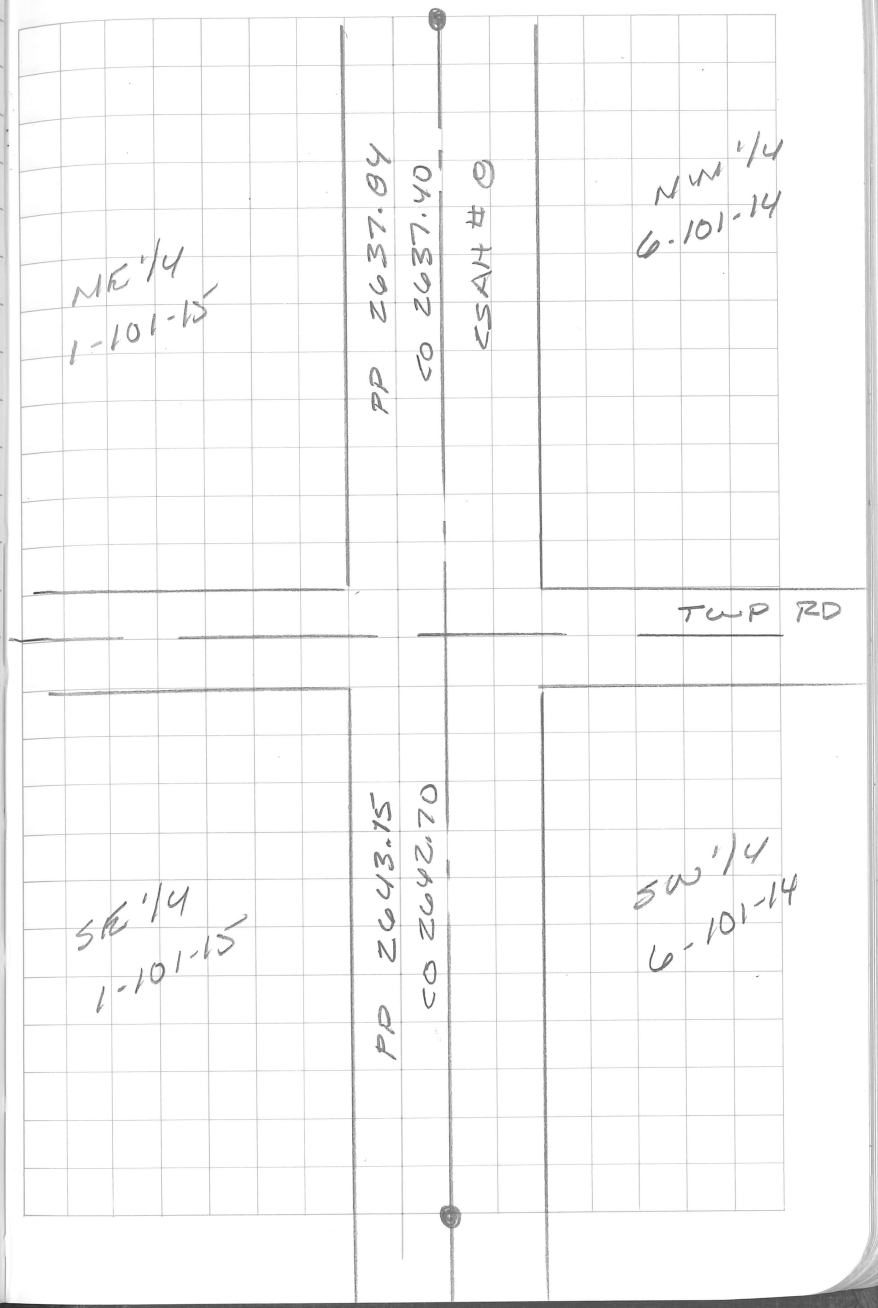

E 1/4 Cor Sec 1-101-15

County Road Plan 1946 shows
1/4 Cor @ ℄ CSAH No 8 and
℄ East-West TWP Road.
Plan also shows a grade
change @ location that could
have destroyed original monumentation.
Reset Corner @ a PP/FT Distance
on a straight line between
NE + SE corners of section 1-101-15
Position fits existing ℄ ℄
No monument set at this time

