
SW COR SEC. 31-101-14

MONUM. CON NOTES STATE -5-26-55
FND. 2" CONC. MON - 10" BELOW
SURFACE.

JHS CREW dug with BACKHOE
ON ℄ E-W ROAD AND ℄ of
740th AVE N. FOUND THREE
1' LONG CONC MONS WITH S/8 Ø
IN CNT. OVER FIELD STONE
5' ± DEEP.
PLACE CAST IRON MON OVER
⅝" ∅. IN CONC. MON.
TWO TIES FROM 1955 AGREE
WITH THIS COR.
(M38.7) 38.3 NE TO COR STEEL FP
(M32.3) 32.2 SE TO PP

10-10-06 SPOKE WITH FARMER
WHO OWNS SE¼ SEC 36.101.15
& HE STATED THAT TWP CARTWAY
WAS CNTERED ON TWP LINE
& THAT IT USED TO RUN N.
THRU THE ENTIRE SEC BUT PART N

7-15-03
Cloudy
80°
HLS
TLM
43

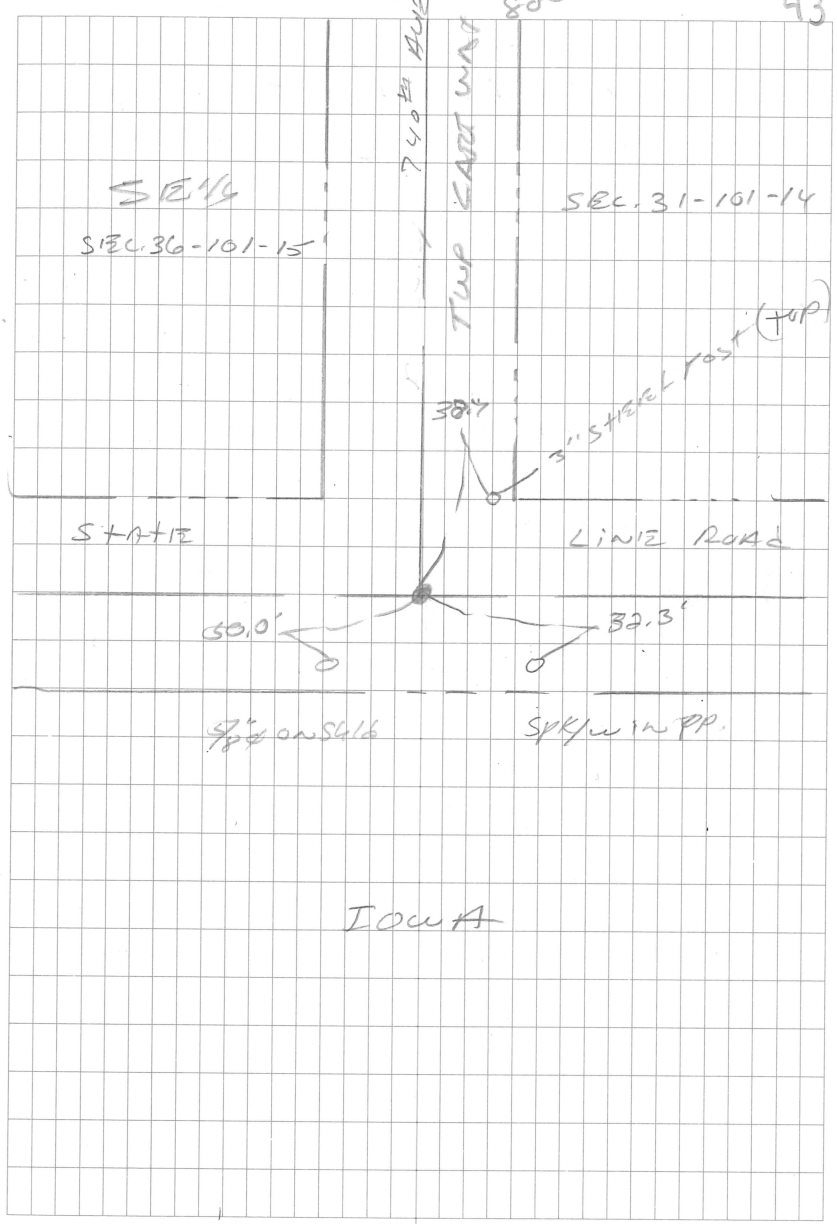

OF HIS FARM WAS ABANDONED 10± YEARS AGO-