
SW cor SEC. 36-103-17
Cert. Filed by JHS
Ray Tucker 15471 CAPPS

7-28-97
cloudy
80°

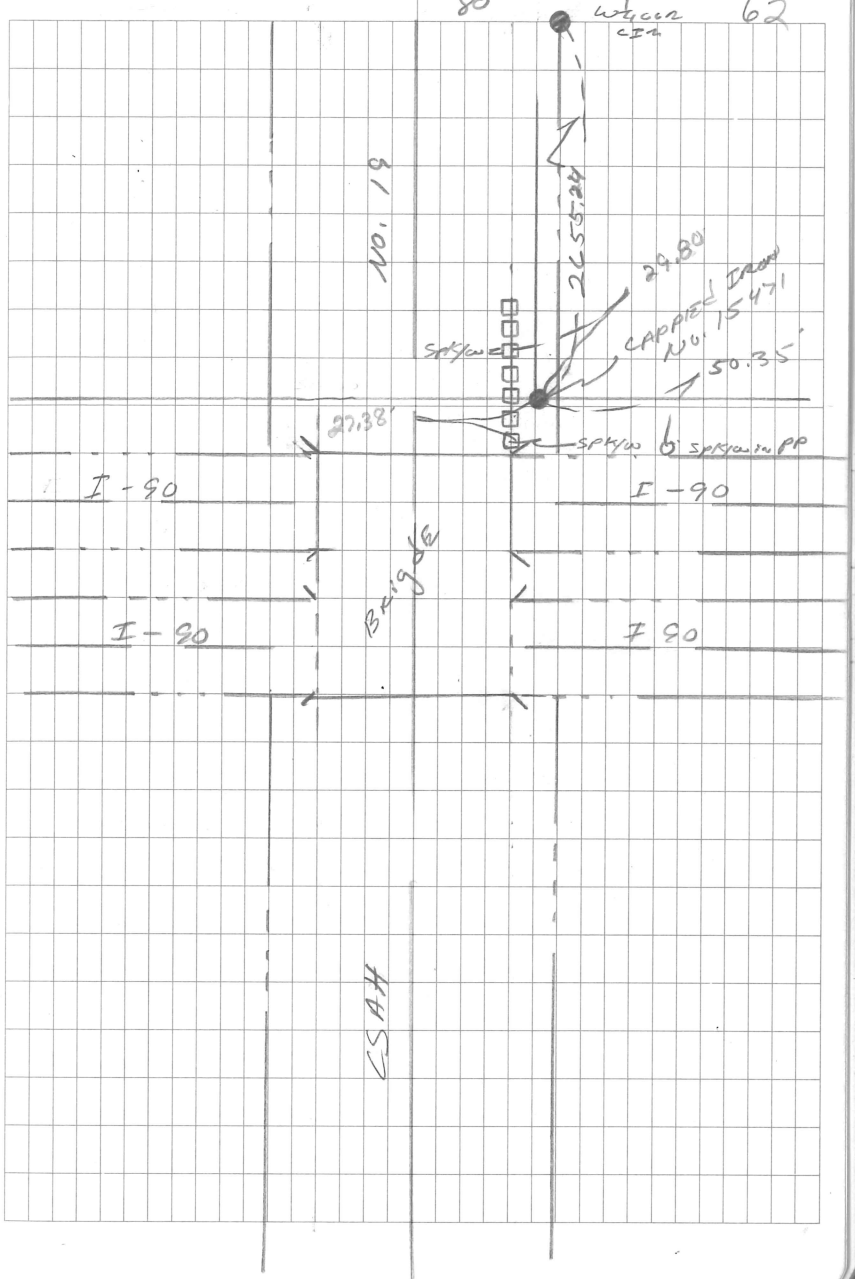

7-28-97
Cloudy
80°

HLS
mkg

60

RE-SET CORNERS ON CSAH #19

TP SW cor SEC. 36
BS NW cor SEC. 36
D 5307.17 V.S 5306.60 .57 LONG
FS AT&T TOWER (D TEX + FEN)
∠ 181°48'31 V.S CALC 181°48'23"
FS W¼ cor SEC. 36
∠ 359, 59°08"
D 2655.24

TP W¼ cor SEC. 36
BS SW cor SEC. 36
D 2655.24
FS NW cor SEC 36
∠ 180°03'37
D 2652.42

TP NW cor SEC. 36
BS W¼ cor SEC. 25.
D 2650.60 VS 2650.73
FS W¼ cor SEC 36
∠ 180°18'40
D 2651.91

FS NW cor SEC. 25

∠ 00°00'60"

D 5301.11 v.s 5301.40 .31 long

TR NW cor SEC. 25

BS W¼ cor SEC. 25

D 2650.92 v.s 2650.62

FS W¼ cor SEC. 24

∠ 180°09'51" chkd 180° 10'37

D 2657.60 2657.45

FS NW cor

∠ 180°03'28

D 2602.61