
W1/4 Cor Sec 11-103-17
Cert. Filed 9-21-91 by JHS
Dug with Co. Backhoe at a point 3' E. So. of ℄ in line with fence North and uncovered a 3/4"ø x 16" long pipe 1' deep Cont digging and found 3" sq. shaft in old road bed at a depth of 3.5' in virgin soil uncover a 10"x10" sq. pointed stone with bold lath on W. side. placed capped 5/8"ø x 16" iron on north side stone and Chn over stone

Stone mon. was 1.9' W and 0.9' So. of Pipe on Surface

2-13-09 SJT, KTW reset magnail @ cor using GPS

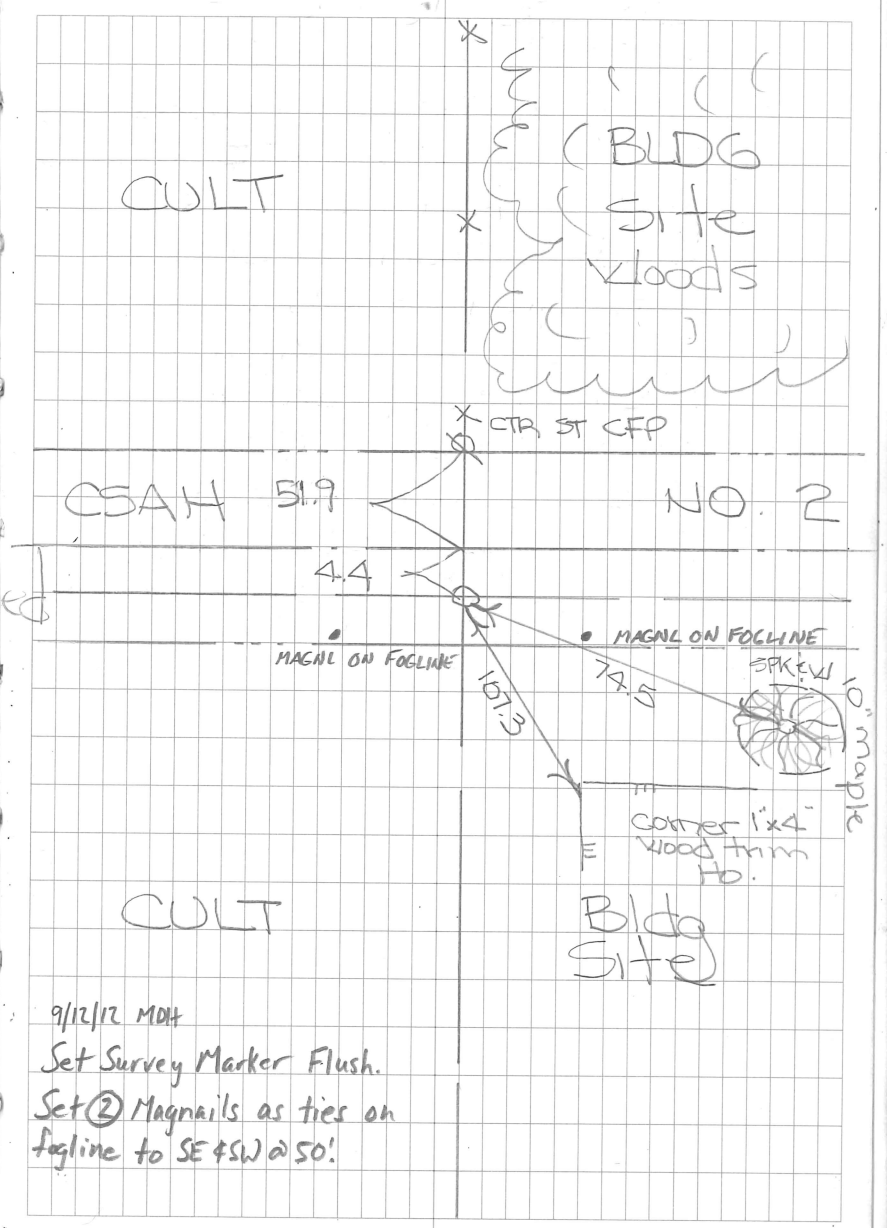

9/12/12 MDH
Set Survey Marker Flush.
Set (2) Magnails as ties on fogline to SE & SW @ 50'.