
NW COR SEC. 6-103-17

5-16-74 JHS CREW SET 5/8" ϕ
SAVE BOOK 166 - pg 26
TIE's - NE COR TREE. BOX - SW 78.20
TREE BOX REPLACED

JHS CREW UNCOVERED 5/8" ϕ
.50± BELOW Rd SURFACE
PLACED CAST IRON MON
OVER 5/8" ϕ FOUND.

10-7-99 HLS
CLOUDY DESK
70°

68

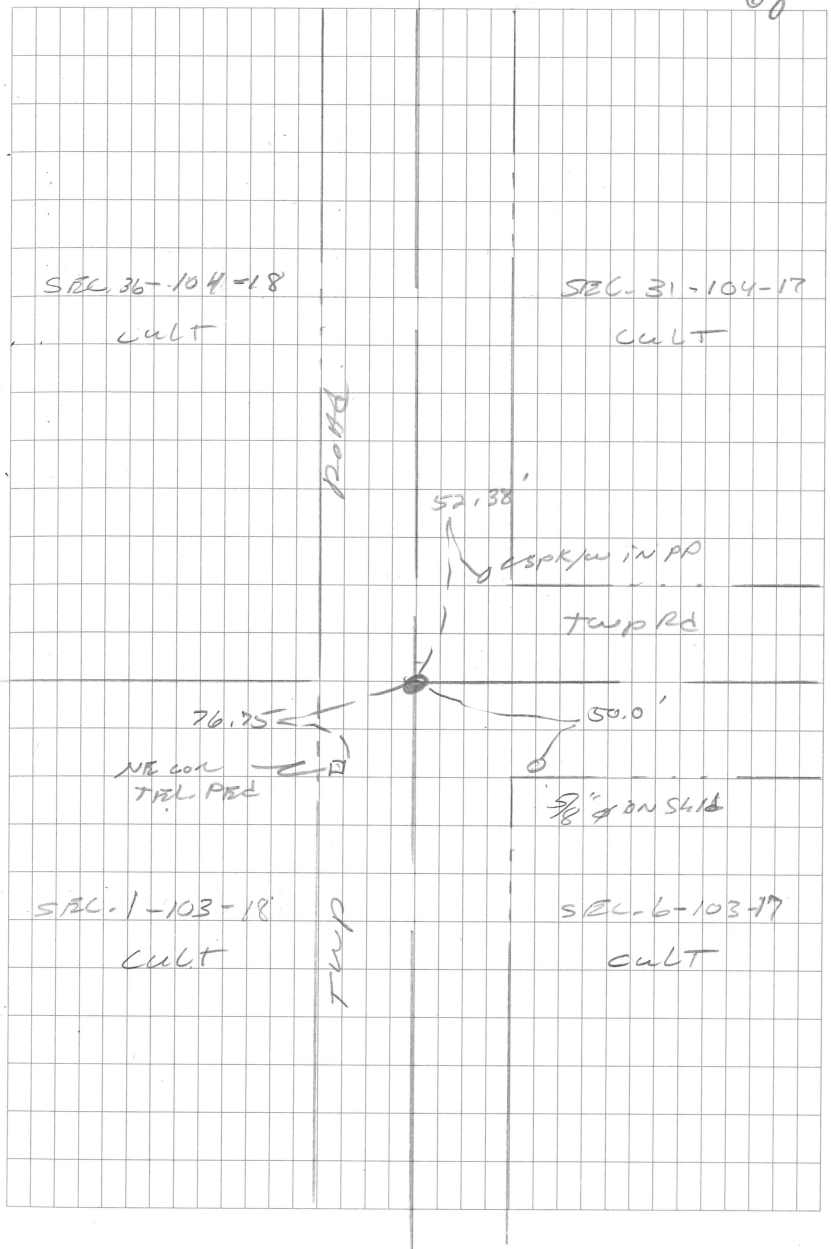

NE CORNER SEC. 1-103-18

Cert. Filed by JHS 10-17-96

OCT 22, 1991 JH & S CREW

DUG WITH Co. BACKHOE

& FOUND 1/2" ϕ x 30" LONG REBAR

FOUND NO FURTHER EVIDENCE

OF PLS CORNER.

SET CIM OVER REBAR

NEED TIE

Nov. 1991 SAW 5

