
8-26-99
CLEAR
85°
HLS
DEK

w/ COR SEC 18-103-17

JHS CREW UNCOVERED CAPPED (1380?) 5/8" ø @ DIST of 2648.85' FROM NW COR, REMOVED CAP & PLACED CAST IRON MON of 5/8" ø, .40± BELOW Rd SURFACE,

SEE pg 77 & 78 of this Book.

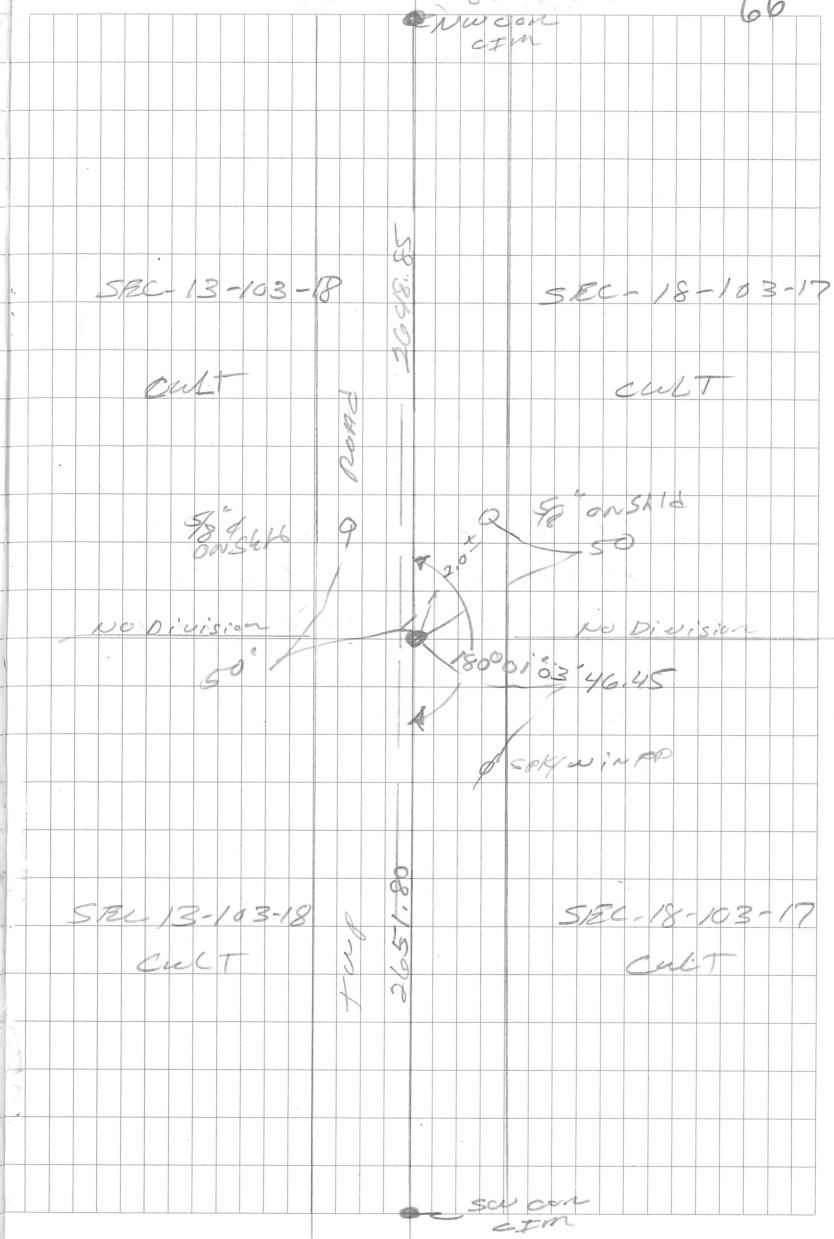

8-26-99 HLS
CLEAR DEK
85°.

77

RESET SW cor SEC. 18-103-17
CORNER DESTORYED by CONSTRUCTION
(REPLACE Bridge) (MOWER Co.)

TO NW cor SEC. 18 — FD CTM
BS N¼ cor SEC. 18
D 2821.74 V.S 2821.77 — FD CAP 5/8"ϕ
B W¼ cor SEC. 18
∠ 89°36'35"
D 2648.85
FS N¼ cor SEC. 13 — FD CTM
∠ 178°54'40"
D 2657.03

TO W¼ cor SEC. 18
BS NW cor SEC 18
D 2648.87
FS SW cor SEC. 18
∠ 180°01'03"
D 2657.80
FS TR. PT-
∠ 180°14'04"
D 3553.90

