
8-26-99 HLS
CLEAR DEK
85°.

77

RESET SW cor SEC. 18-103-17
CORNER DESTORYED by CONSTRUCTION
(REPLACE Bridge) (MOWER Co.)

TO NW cor SEC. 18 — FD CTM
BS N¼ cor SEC. 18
D 2821.74 V.S 2821.77 — FD CAP 5/8"ϕ
B W¼ cor SEC. 18
∠ 89°36'35"
D 2648.85
FS N¼ cor SEC. 13 — FD CTM
∠ 178°54'40"
D 2657.03

TO W¼ cor SEC. 18
BS NW cor SEC 18
D 2648.87
FS SW cor SEC. 18
∠ 180°01'03"
D 2657.80
FS TR. PT-
∠ 180°14'04"
D 3553.90

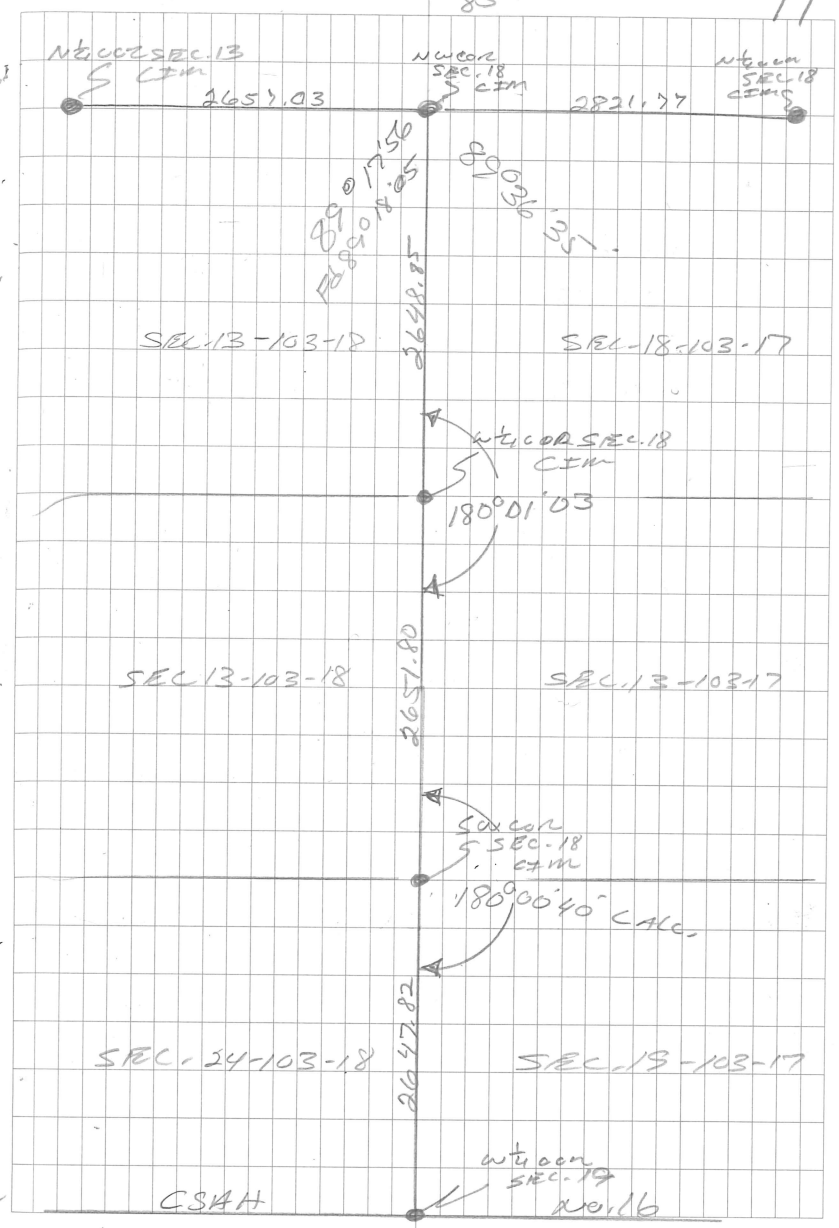

SW Cor Sec 7-103-17

Dug on ℄℄ in line with fence north uncoverd a 6" dia heavy wall pipe in nest of stones 2' below road surface in old road bed set Cim over F 5/8"ϕ iron 2.2' E & 0.5' N. of true corner nothing under it, removed and chucked

