
BEL-AIR — FIRST ADDITION

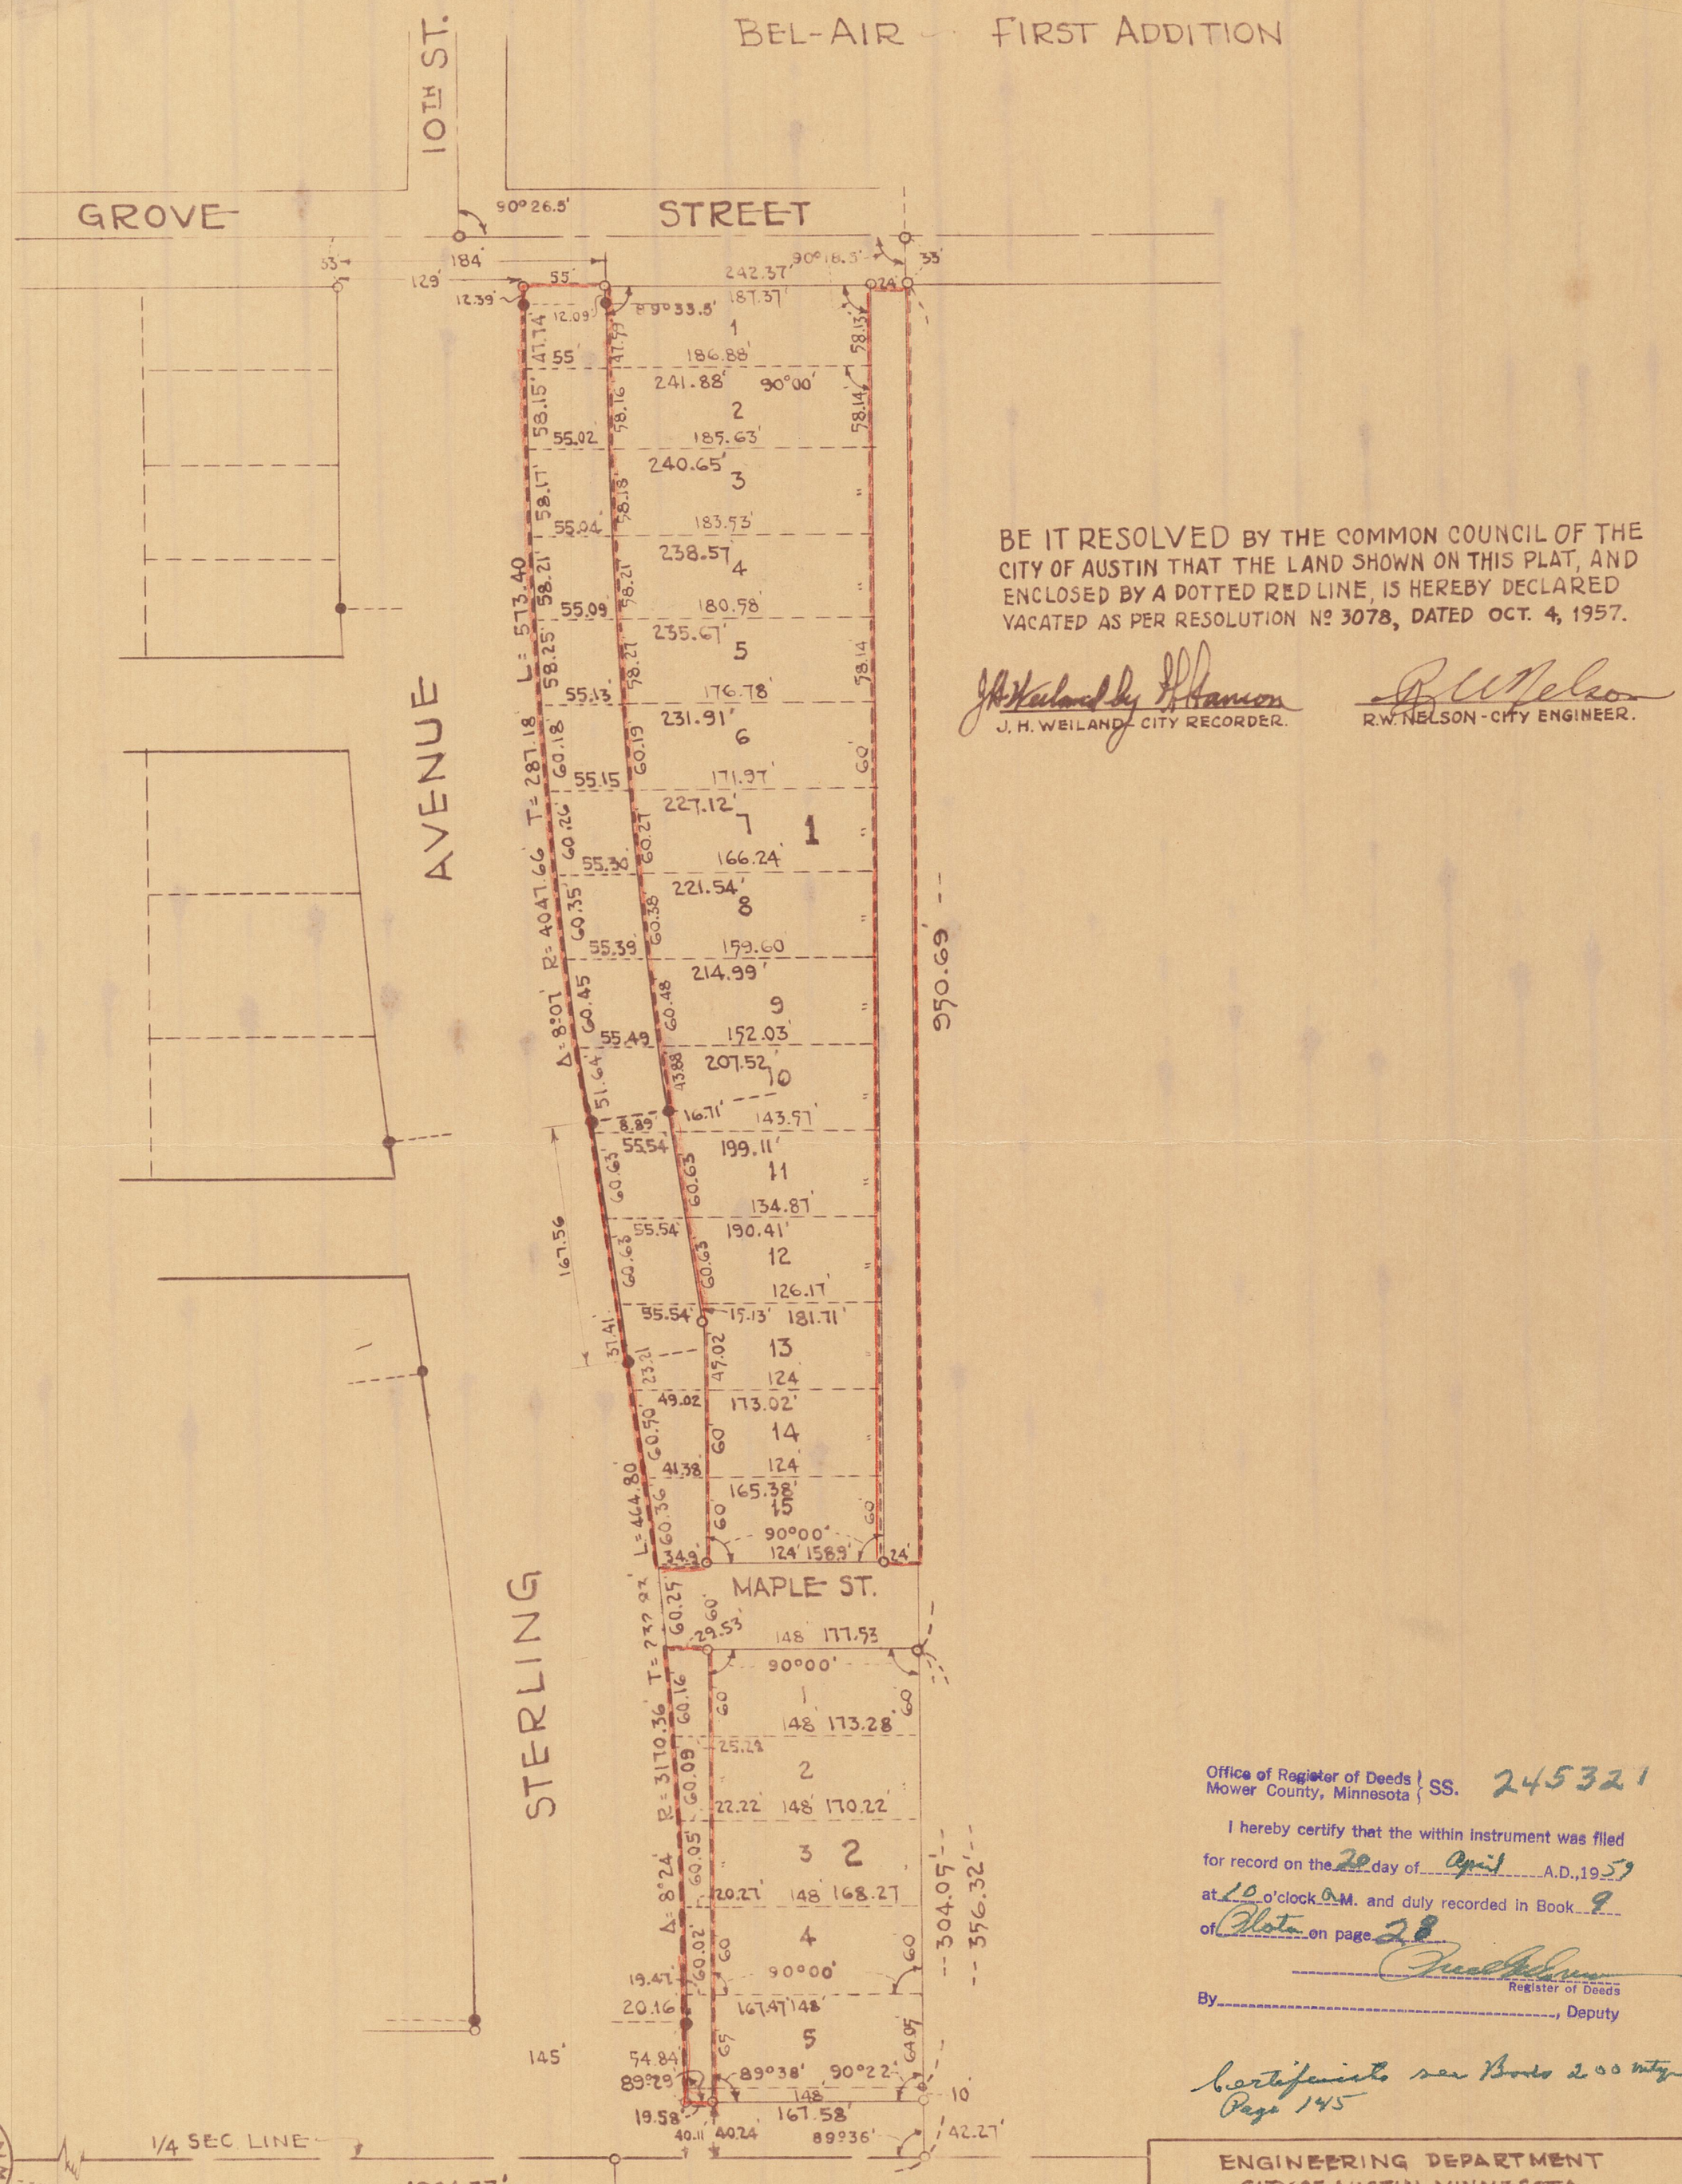

BE IT RESOLVED BY THE COMMON COUNCIL OF THE CITY OF AUSTIN THAT THE LAND SHOWN ON THIS PLAT, AND ENCLOSED BY A DOTTED RED LINE, IS HEREBY DECLARED VACATED AS PER RESOLUTION Nº 3078, DATED OCT. 4, 1957.

J. H. Weiland by P. Hanson
J. H. WEILAND - CITY RECORDER.

R. W. Nelson
R.W. NELSON - CITY ENGINEER.

Office of Register of Deeds } SS. 245321
Mower County, Minnesota }

I hereby certify that the within instrument was filed for record on the 29 day of April A.D., 1957 at 10 o'clock A.M. and duly recorded in Book 9 of Plats on page 28

Register of Deeds

By _____, Deputy

Certificate see Book 200 mtgs Page 145

ENGINEERING DEPARTMENT
CITY OF AUSTIN MINNESOTA

PLAT SHOWING THE PROPOSED VACATION OF A PORTION OF STERLING AVE. IN BEL-AIR FIRST ADDITION TO AUSTIN, MINNESOTA.

SCALE 1" = 100'

DATE 2-8-57

R. W. NELSON CITY ENGINEER