
# M. N. Clausen's Re-arrangement

## of

# Fay R. Smith's Addition to Austin

Survey make and plat drawn by M. N. Clausen, Surveyor and Civil Engineer.

Scale: 30 feet to one inch

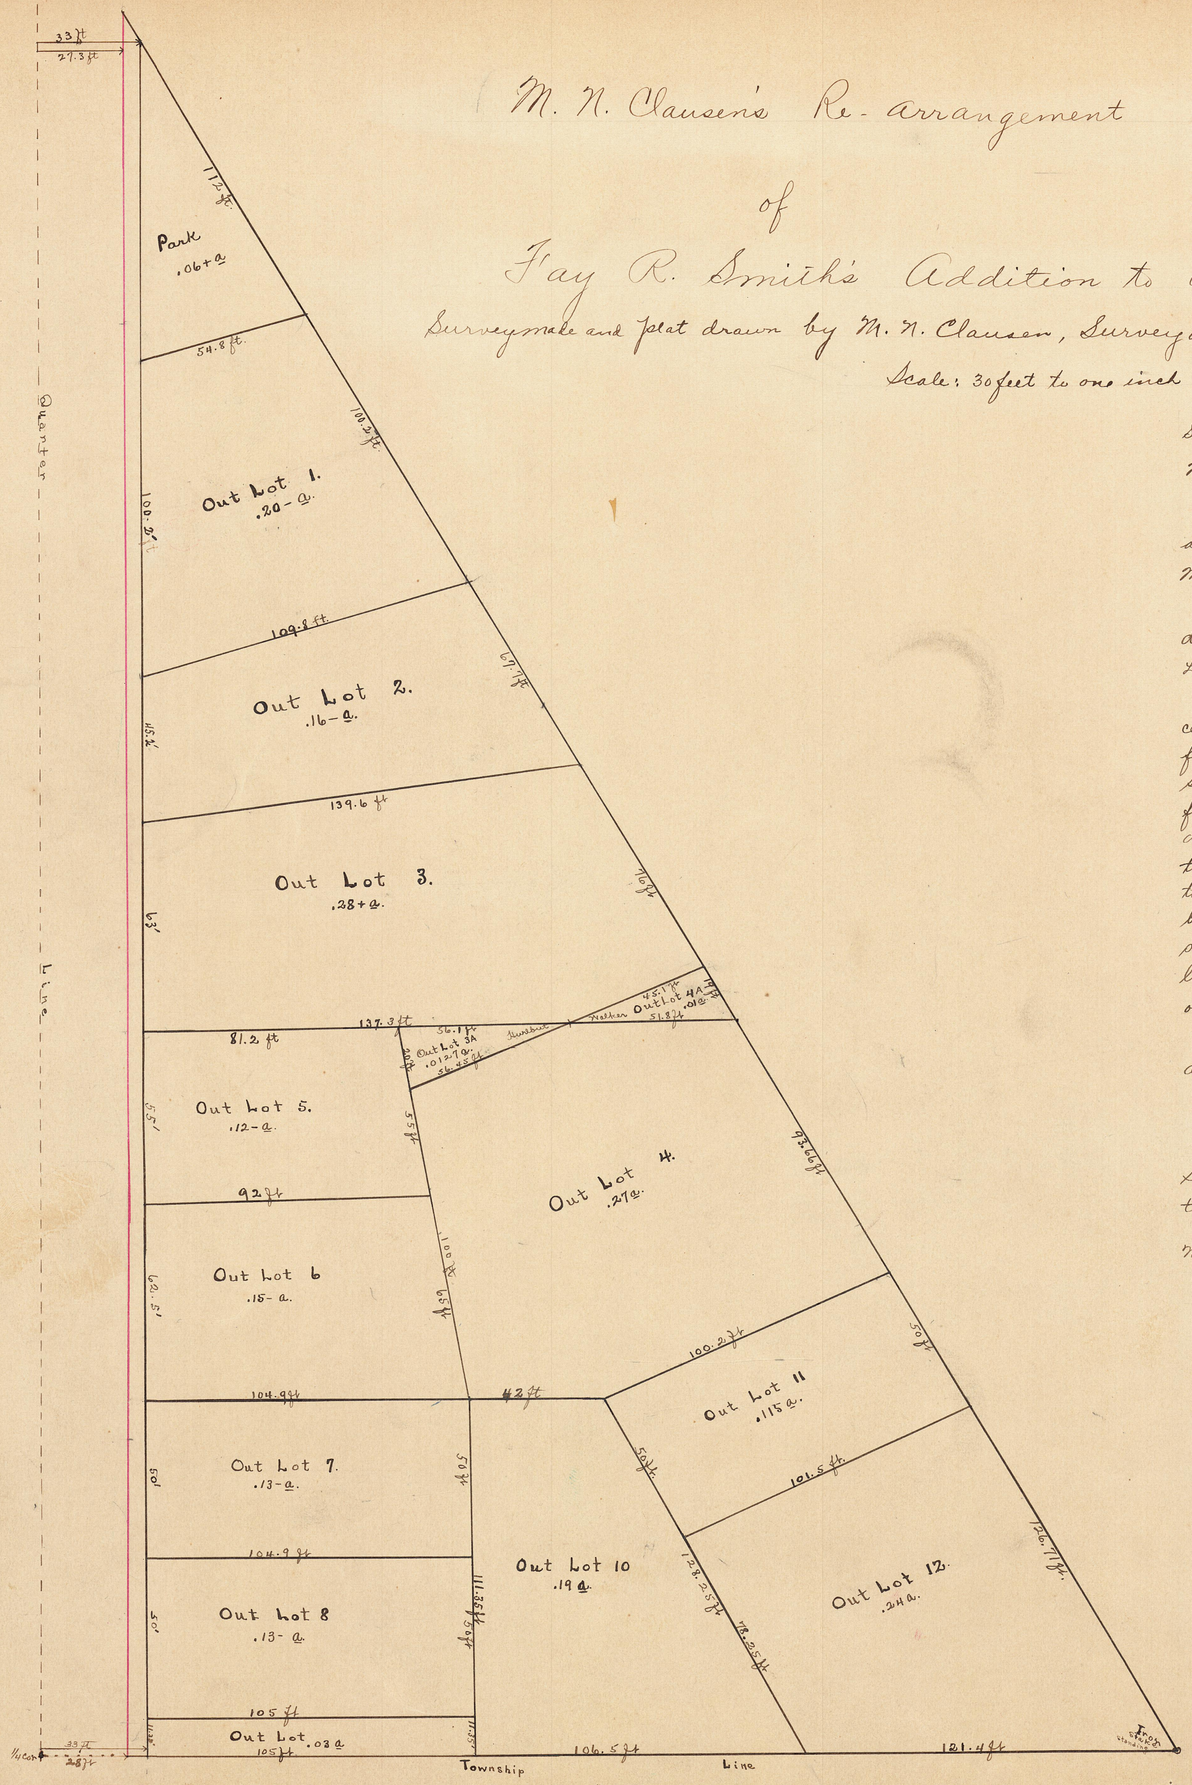


State of Minnesota }
Mower County } ss

I, M. N. Clausen, being duly sworn, depose and say that I am a duly qualified and acting civil engineer and surveyor, located and practicing my profession in Austin, Mower County, Minnesota and surrounding territory.

I certify that at the request of the County Auditor of Mower County, Minn., I did make a survey of the property described in the plat and descriptions of Out Lots hereto attached.

I certify and state that the plat which I have drawn and to which this certificate is attached and measurements shown thereon in feet and decimal parts of a foot, are correct and true and that it accurately describes the several parcels of land surveyed and shown by said plat. The location of the quarter-line running north from the Quarter post at the intersection of Kenwood Ave. and Freeborn Street, was determined by measurement from the East boundary line of Woodlawn Park Addition to Austin, the recorded plat of same showing the distance between paid lines to be 40 feet, and the black line drawn on the attached plat marks the west boundary line of Fay R. Smith's Additions to Austin, being 33 feet from the aforepaid quarter line in accordance with the recorded plat of same. And the red line west of said Black line, indicates the line as used by the property owners and the side walk.

The particular parcels of land surveyed and shown by said plat, are designated as Out Lots 1 to 12 inclusive as well as Out Lots 3a and 4a.

Dated March 29th A. D. 1920.
At Austin, Minn.

M. N. Clausen
Civil Engineer & Surveyor.

Subscribed and sworn to before me
this 29th day of March 1920.
A. N. Wright, Notary Public
Notarial Seal. My com. expires July 31, 1922.

O. K. A. B. Overland
May 14, 1920 City Engineer

Taxes paid and transfer entered
this 21 day of May 1920
O. J. Simmons
County Auditor.

Office of Register of Deeds,
Mower County,
State of Minnesota, } 82496 1/2

I hereby certify that the within instrument was filed for record in this office on the 21 day of May 1920 at 2 o'clock P. M. and duly recorded in Book 4 Plats Page 15

J. S. Wood
Register of Deeds,
By _____ Deputy.